
 <p>WDA DESIGN GROUP INCORPORATED 16057 TAMPA PALMS BLVD. WEST #160 TAMPA, FLORIDA 33647 TELEPHONE 813 988 280 FAX 813 988 280</p>	<p>PROJ. NO: 513400</p> <p>DATE: 03.20.13</p>	<p>ALL ROOM SIZES ARE APPROXIMATE</p> <p>SCALE: 1/8" = 1'-0"</p> <p>NORTH</p>	<p>PROJECT NAME: SUITE 340 3RD FLOOR TAMPA MEDICAL TOWER 2121 W. MARTIN LUTHER KING BLVD. TAMPA, FLORIDA 33607</p>
	<p>SHEET NAME: AS-BUILT PLAN</p>		

3RD FLOOR KEY PLAN
NOT TO SCALE
NORTH

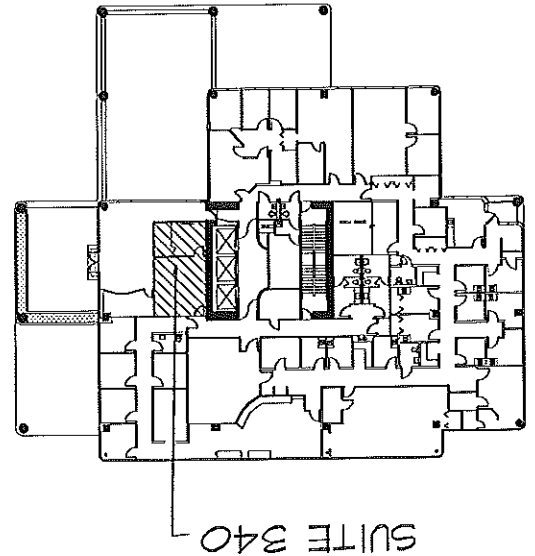

LEASEABLE AREA = 526 RSF

